


TRAFFIC CONTROL PLAN
MISSION ST & GENEVA AVE IMPROVEMENT PROJECT - 0000005626 SEWER
WORK PLAN - GENEVA AVE FROM VIENNA ST TO ATHENS ST 3

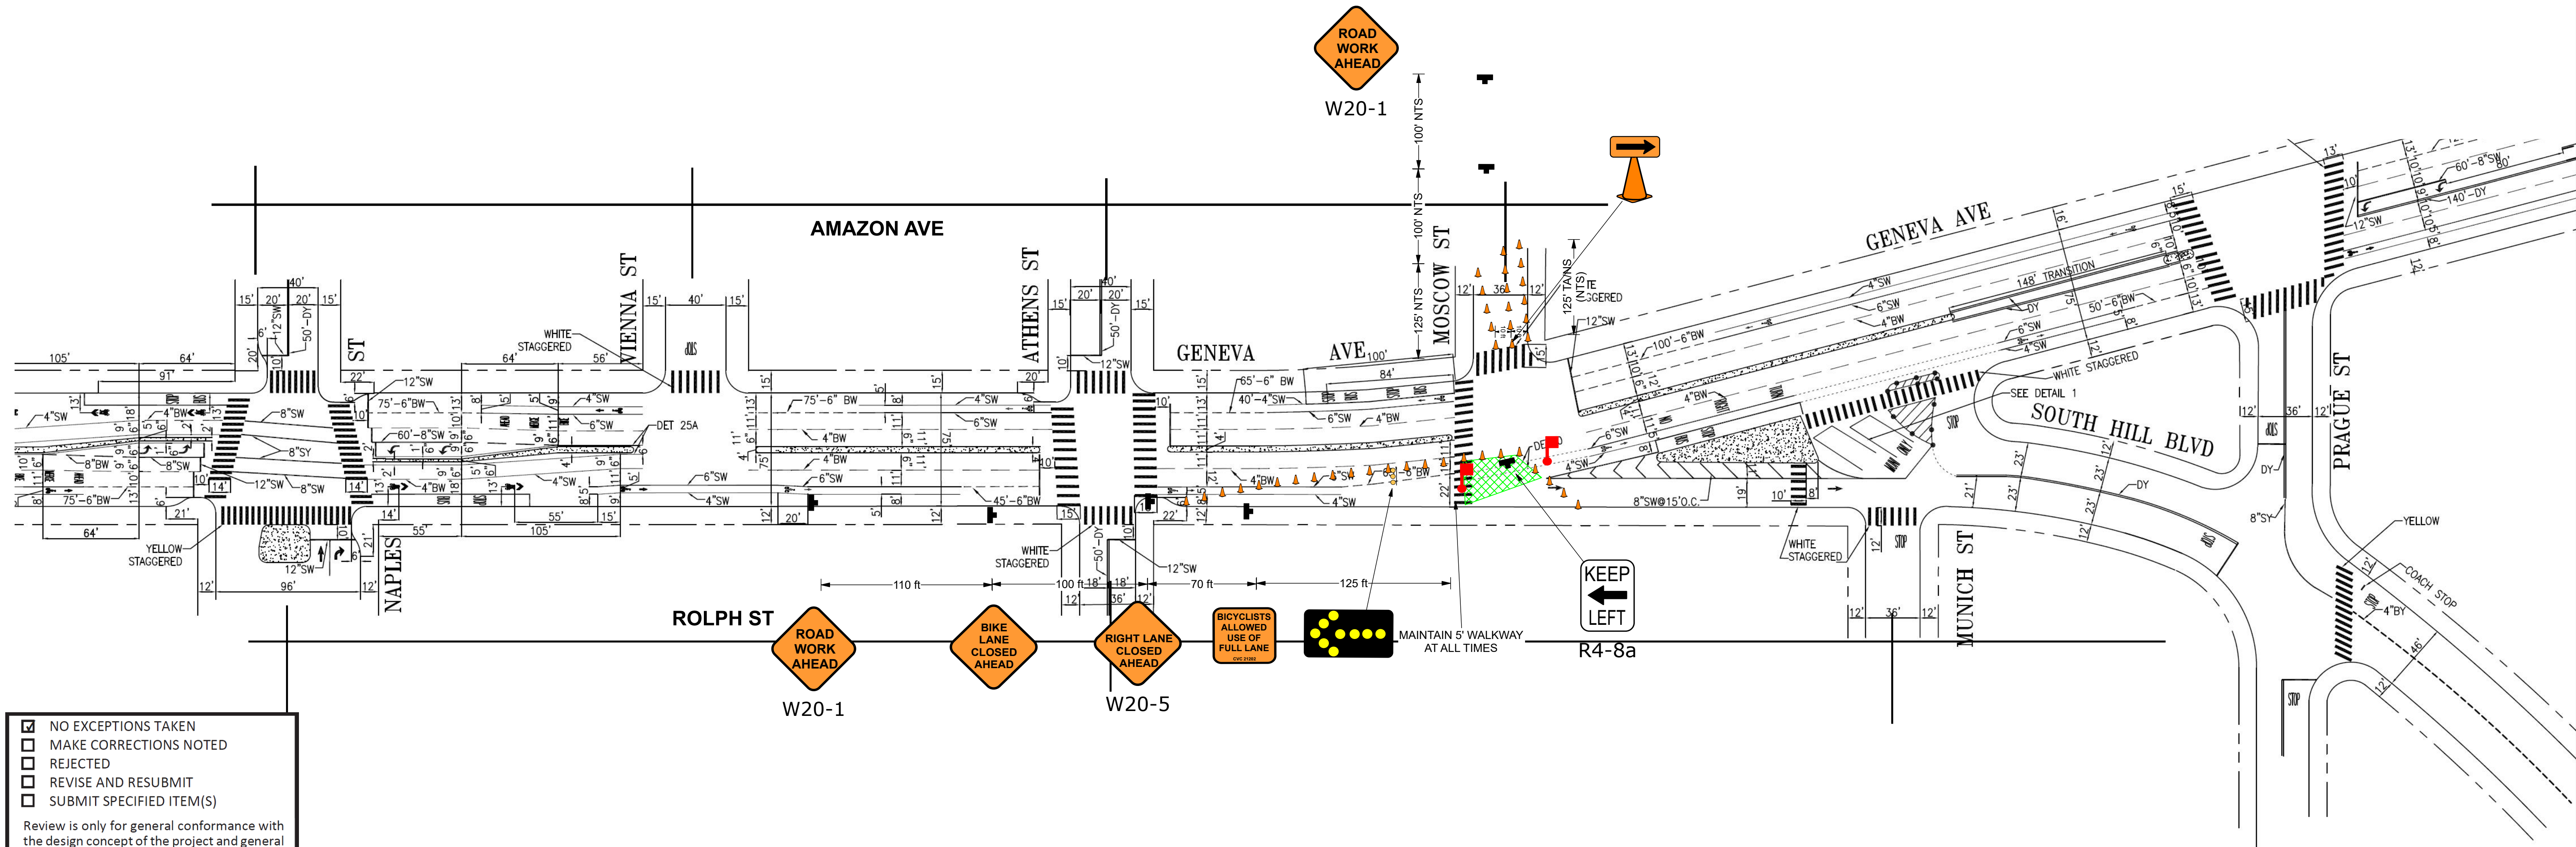

- ☒ NO EXCEPTIONS TAKEN
☐ MAKE CORRECTIONS NOTED
☐ REJECTED
☐ REVISE AND RESUBMIT
☐ SUBMIT SPECIFIED ITEM(S)

Review is only for general conformance with the design concept of the project and general compliance with the requirements of the contract documents. Any action shown is subject to the requirements of the plans and specifications. Contractor's responsibilities include, but are not limited to actual dimensions which shall be confirmed and correlated at the job site; preferred fabrication processes and techniques of construction; coordination of the contractor's work with that of all other trades; and the satisfactory performance of the contractor's work.

Sustainable Streets Division
 San Francisco Municipal Transportation Agency
 City and County of San Francisco

By: *[Signature]* Date: **11/29/22**

Legend

- Type III Barricade
- 28" Traffic Cone
- Delineator
- Pedestrian Barricade
- Work Area
- Sign and Stand
- Direction of Travel
- Concrete K-Rail
- Crash Cushion
- NTS Not To Scale
- T/ANS Tow-Away/No Stopping
- Parking Control Officer
- Flagger
- Type I Barricade
- Flashing Beacon

Plan Scale

1" = 50'

Traffic Lane Requirements
Number and Width of Lanes

STREET	TIME	NORTHBOUND	SOUTHBOUND	EASTBOUND	WESTBOUND
SEWER WORK					
GENEVA AVENUE					
Vienna St to Athens St *(MC) β	9AM - 4PM (M-F) At Other Times	-	-	Full Rdwy	1@12'
Athens St to 50' east of Moscow St *(MC) β	8AM - 4PM (M-F) At Other Times	-	-	1@12' Full Rdwy	Full Rdwy
<u>Cross Streets for Geneva Ave</u>					
Athen St south of Geneva Ave ⊙	8AM - 4PM (M-F) At Other Times	Closed ⊙ Full Rdwy	1@12' Full Rdwy	-	-
Moscow St *(MC)	At All Times	Full Rdwy	Full Rdwy	-	-
South Hill Blvd +	8AM - 4PM (M-F) At Other Times	-	-	1@12' Full Rdwy	-



3450 3RD ST #3G
 SAN FRANCISCO, CA 94124
 415-206-1700 PHONE
 415-206-1711 FAX
 INFO@CMCTRAFFIC.COM

LICENSE NO 792059
 CLASS A, 31, C21

WBE/SBE/LBE/DBE CERTIFIED
 WWW.CMCTRAFFIC.COM

Date: 11/22/2022 **Author:** RC/CM **Project:** MISSION ST & GENEVA AVE
Client: BAUMAN LANDSCAPE **Location:** SAN FRANCISCO **TCP:** 051
CMC Job #: 3405

Comments:

- 1) WORK HOURS:
- 2) CONTRACTOR TO VERIFY EXISTING STRIPING IS ACCURATE PRIOR TO START OF WORK.
- 3) ALL TRAFFIC CONTROL SHALL CONFORM TO THE LATEST EDITION OF CA MUTCD.
- 4) ALL TRAFFIC CONTROL DEVICES SHALL BE RETROREFLECTIVE IF SETUP DURING HOURS OF DARKNESS.
- 5) MAINTAIN LOCAL ACCESS TO BUSINESSES AND RESIDENTS AT ALL TIME.
- 6) THE CONTRACTOR SHALL NOT PREVENT OR DELAY THE OPERATION OF MASS TRANSIT VEHICLES AT ANY TIME.
- 7) THE CONTRACTOR SHALL PERFORM THE APPROPRIATE MEASURES TO ENSURE THE SAFETY OF BICYCLISTS ON ALL STREET ON WHICH THERE IS CONSTRUCTION.