


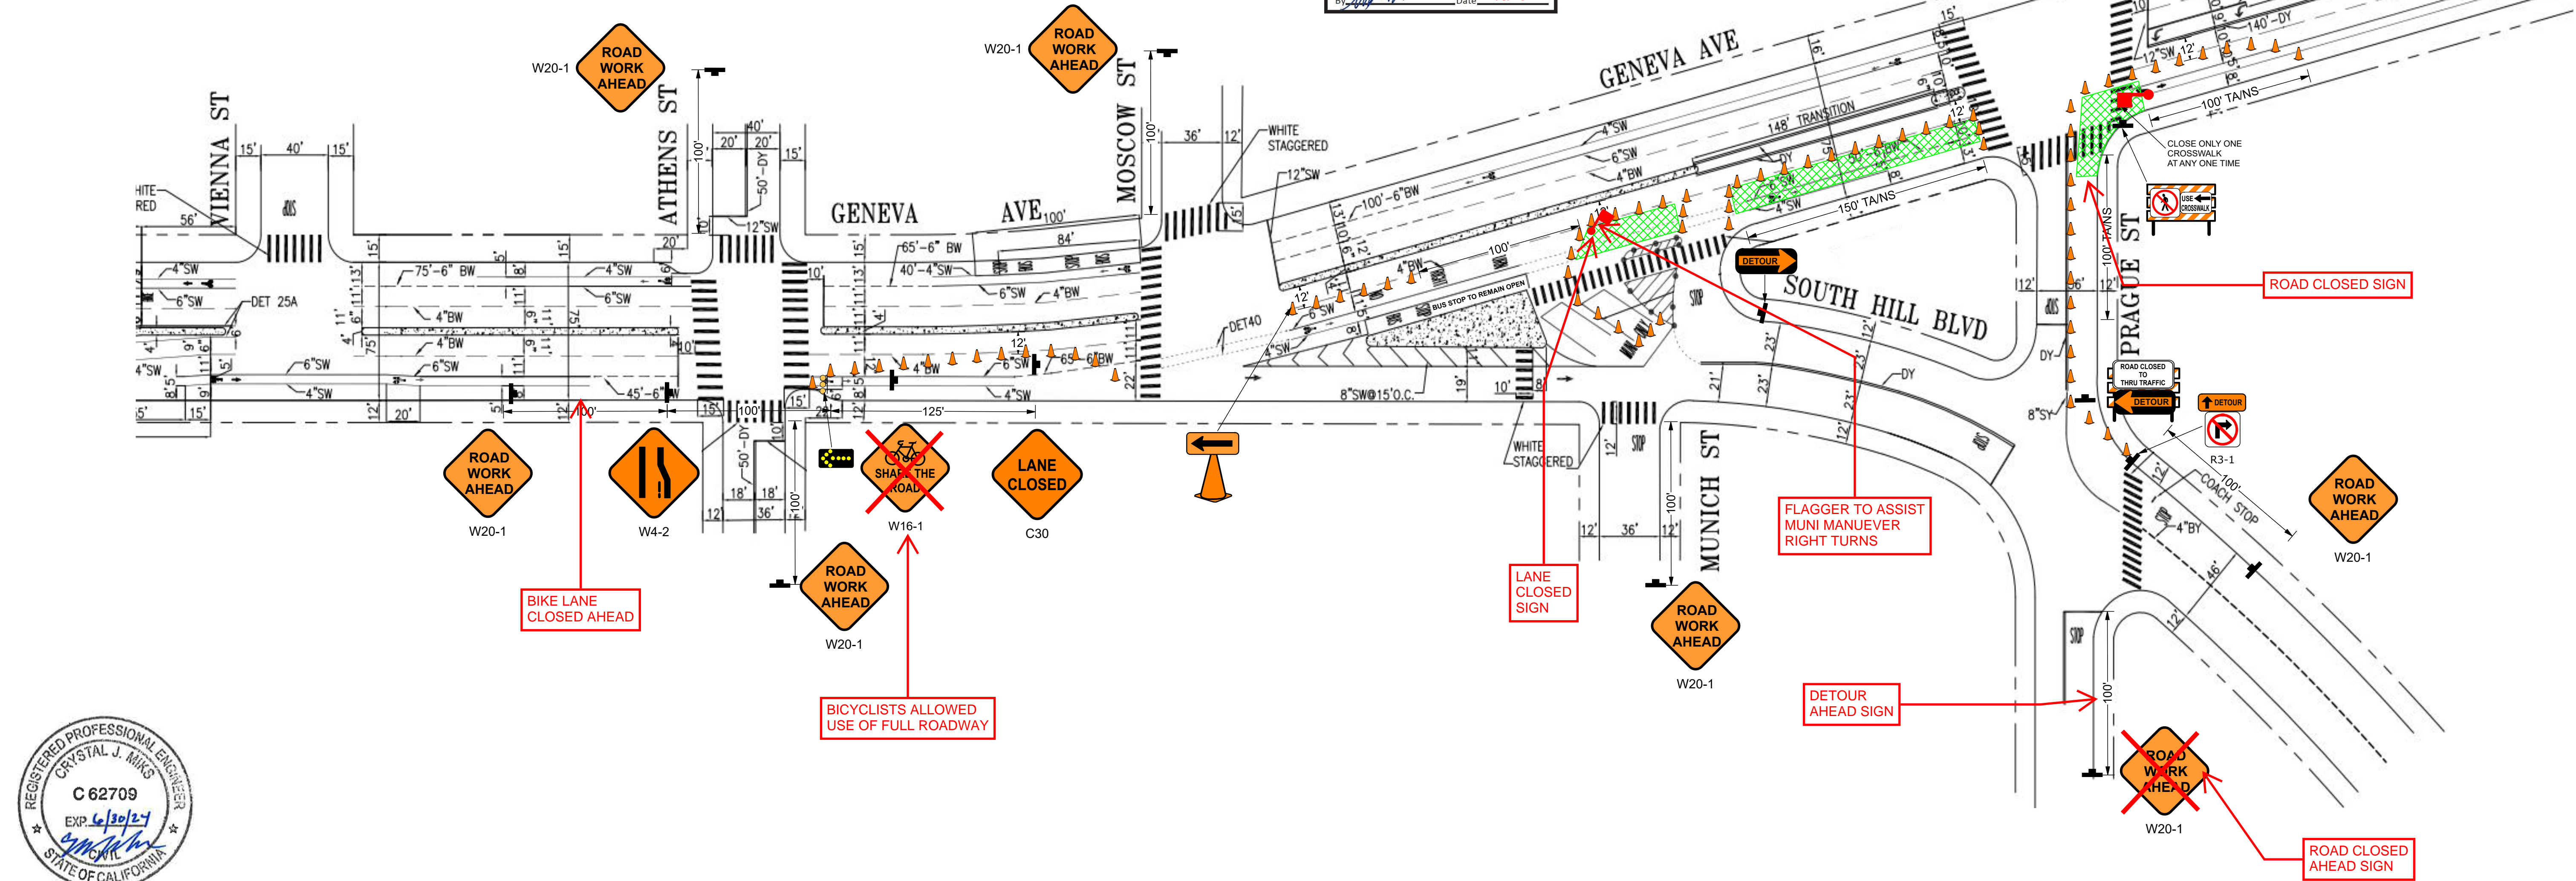
TRAFFIC CONTROL PLAN  
MISSION ST & GENEVA AVE IMPROVEMENT PROJECT - 0000005626  
BASE REPAIR - GENEVA AVE, ATHENS ST TO SOUTH HILL BLVD

Traffic Lane Requirements Number and Width of Lanes					
STREET	TIME	NORTHBOUND	SOUTHBOUND	EASTBOUND	WESTBOUND
BASE REPAIR WORK					
GENEVA AVENUE					
Lisbon St to Prague St (MC) β	8AM – 9AM (M-F) 9AM – 4PM (M-F) At Other Times	- - -	- - -	1@12' 1@12' Full Rdwy	Full Rdwy 1@12' Full Rdwy
Cross Streets for Geneva Avenue South Hill Blvd ©	8AM - 4PM (M-F) At Other Times	- -	- -	Closed © Full Rdwy	- -
Munich St (MC)	8AM - 4PM (M-F) At Other Times	1@16' (Muni Only) Full Rdwy	- -	- -	- -
Prague St © (MC)	8AM – 4PM (M-F) At Other Times	Closed © Full Rdwy	1@12' Full Rdwy	- -	- -

☐ NO EXCEPTIONS TAKEN  
☒ MAKE CORRECTIONS NOTED  
☐ REJECTED  
☐ REVISE AND RESUBMIT  
☐ SUBMIT SPECIFIED ITEM(S)

Review is only for general conformance with the design concept of the project and general compliance with the requirements of the contract documents. Any action shown is subject to the requirements of the plans and specifications. Contractor's responsibilities include, but are not limited to actual dimensions which shall be confirmed and correlated at the job site; preferred fabrication processes and techniques of construction; coordination of the contractor's work with that of all other trades; and the satisfactory performance of the contractor's work.

Sustainable Streets Division  
San Francisco Municipal Transportation Agency  
City and County of San Francisco  
By:  Date: 2/6/23



**Legend**

28" Traffic Cone

Delineator

Pedestrian Barricade

Work Area

Sign and Stand

Type I Barricade

Type III Barricade

Flagger

Parking Control Officer

NTS Not To Scale

Towaway/No Stopping

**Table 6C-3(CA). Taper Length Criteria for Temporary Traffic Control Zones**  
(for 12 feet Offset Width)

Speed* S (mph)	Merging L (feet)	Shifting L/2 (feet)	Shoulder L/3 (feet)	Down Stream (feet)***
20	80	40	27	50
25	125	63	42	50
30	180	90	60	50
35	245	123	82	50
40	320	160	107	50
45	540	270	180	50
50	600	300	200	50
55	660	330	220	50
60	720	360	240	50
65	780	390	260	50
70	840	420	280	50
75	900	450	300	50

\*\*\* - Posted speed limit, off-peak 85th-percentile speed prior to work starting, or the anticipated operating speed in mph.

For speeds of 40 mph or less, L = WS/60

For speeds of 45 mph or more, L = WS

Where: L = taper length in feet

W = width of offset in feet

S = posted speed limit, off-peak 85th-percentile speed prior to work, or the anticipated operating speed in mph

\*\*\* - Maximum downstream taper length is 100 feet. See Section 6C.08.

**Table 6F-101(CA). Maximum Spacing of Channelizing Devices**

Speed (mph)	Taper** (feet)	Tangent (feet)	Conflict** (feet)
20	20	40	10
25	25	50	12
30	30	60	15
35	35	70	17
40	40	80	20
45	45	90	22
50	50	100	25
55	50	100	25
60	50	100	25
65	50	100	25
70	50	100	25
75	50	100	25

\*\*\* Use on intermediate and short-term projects for taper and tangent sections where there are no pavement markings or where there is a conflict between existing pavement markings and channelizing devices.

**Table 6C-1. Recommended Advance Warning Sign Spacing**

Road Type	Distance Between Signs**		
	A	B	C
Urban - 25 mph or less***	100 feet	100 feet	100 feet
Urban - more than 25 mph to 40 mph***	250 feet	250 feet	250 feet
Urban - more than 40 mph***	350 feet	350 feet	350 feet
Rural	500 feet	500 feet	500 feet
Expressway/Freeway	1,000 feet	1,500 feet	2,840 feet

\*\* The column headings A, B, and C are the dimensions shown in Figures 6H-1 through 6H-46. The A dimension is the distance from the transition or point of restriction to the first sign. The B dimension is the distance between the first and second signs. The C dimension is the distance between the second and third signs. (The "first sign" is the sign in a three-sign series that is closest to the TTC zone. The "third sign" is the sign that is furthest upstream from the TTC zone.)

\*\*\* Posted speed limit, off-peak 85th-percentile speed prior to work starting, or other anticipated operating speed in mph.

**Plan Scale**  
1" = 50'

3450 3RD ST #3G  
SAN FRANCISCO, CA 94124  
415-206-1700 PHONE  
415-206-1711 FAX  
INFO@CMCTRAFFIC.COM

LICENSE NO. 792059  
CLASS A, 31, C21  
WBE/SBE/LBE/DBE CERTIFIED  
WWW.CMCTRAFFIC.COM

**Date:** 01/19/2023 **Author:** KMH **Project:** MISSION ST AND GENEVA AVE  
**Client:** BAUMAN LANDSCAPE **Location:** SAN FRANCISCO **TCP:** 084  
**Job #:** 3405 **Rev:** 0

**Comments:**

1) WORK HOURS: SEE TRAFFIC LANE REQUIREMENTS

2) CONTRACTOR TO VERIFY EXISTING STRIPING IS ACCURATE PRIOR TO START OF WORK.

3) ALL TRAFFIC CONTROL SHALL CONFORM TO THE LATEST EDITION OF CA MUTCD.

4) ALL TRAFFIC CONTROL DEVICES SHALL BE RETROREFLECTIVE IF SETUP DURING HOURS OF DARKNESS.

5) THE CONTRACTOR SHALL BE ALLOWED TO WORK ON TWO (2) BLOCKS AND/OR TWO (2) INTERSECTIONS ON ANY ONE DAY NOT TO EXCEED 1,200 LINEAR FEET FOR CONCRETE BASE REPAIR WORK.

8) THE CONTRACTOR SHALL NOTIFY SFMTA AT LEAST (10) WORKING DAYS IN ADVANCE OF DOING ANY WORK IN EXISTING PASSENGER LOADING AND UNLOADING ZONE. THE SFMTA MAY TEMPORARILY AUTHORIZE THE RELOCATION OF THESE ZONES.

9) THE CONTRACTOR SHALL NOT PREVENT OR DELAY THE OPERATION OF MASS TRANSIT VEHICLES AT ANY TIME.