
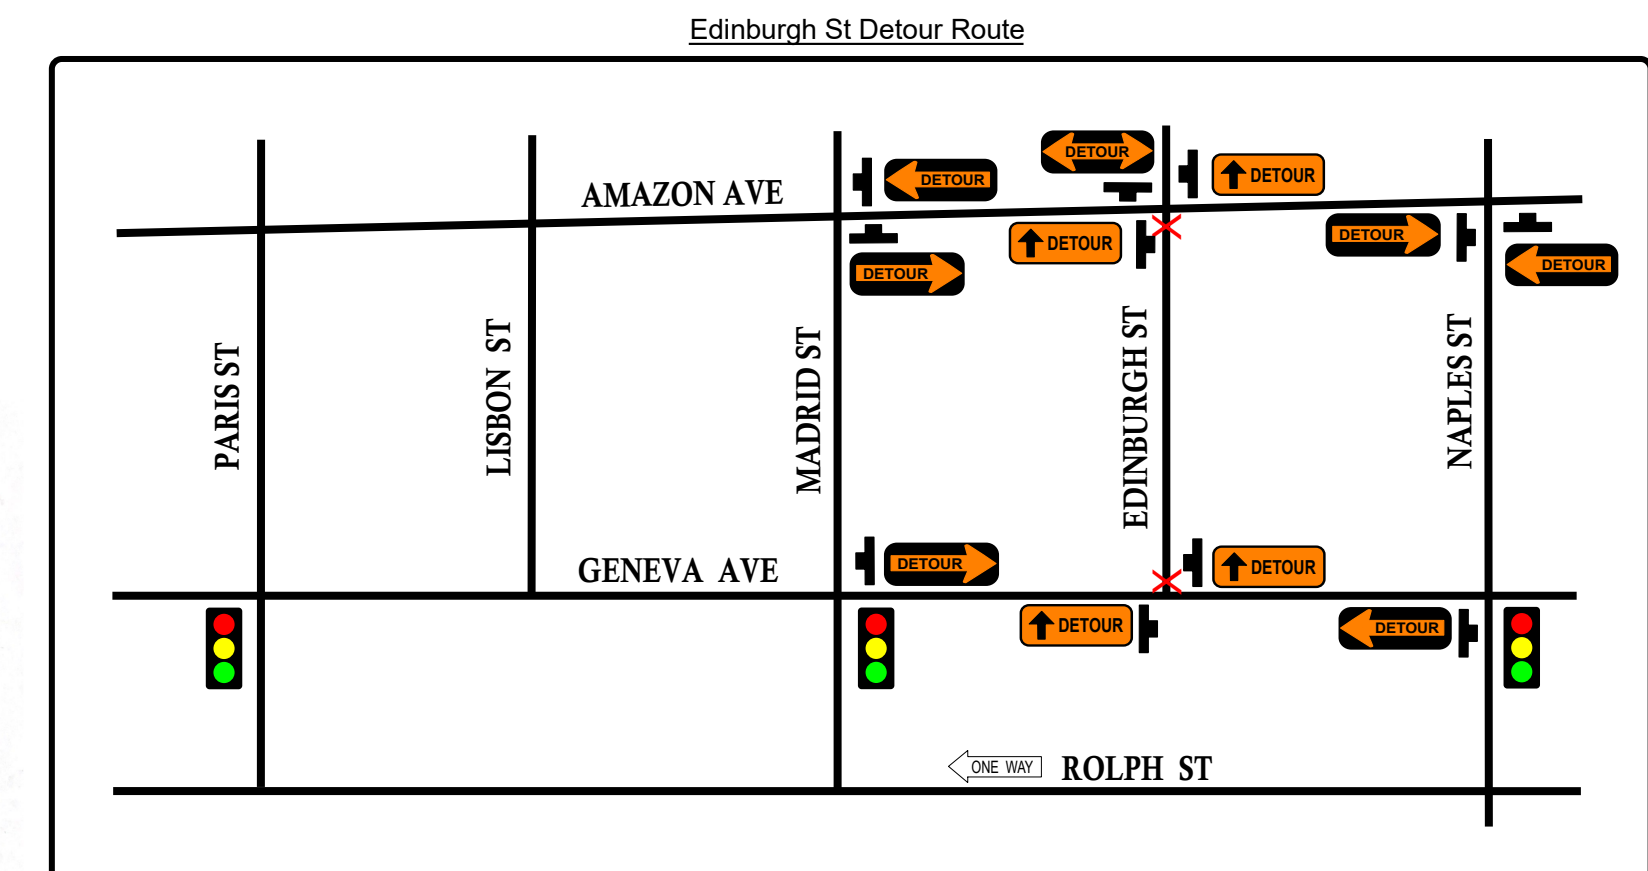
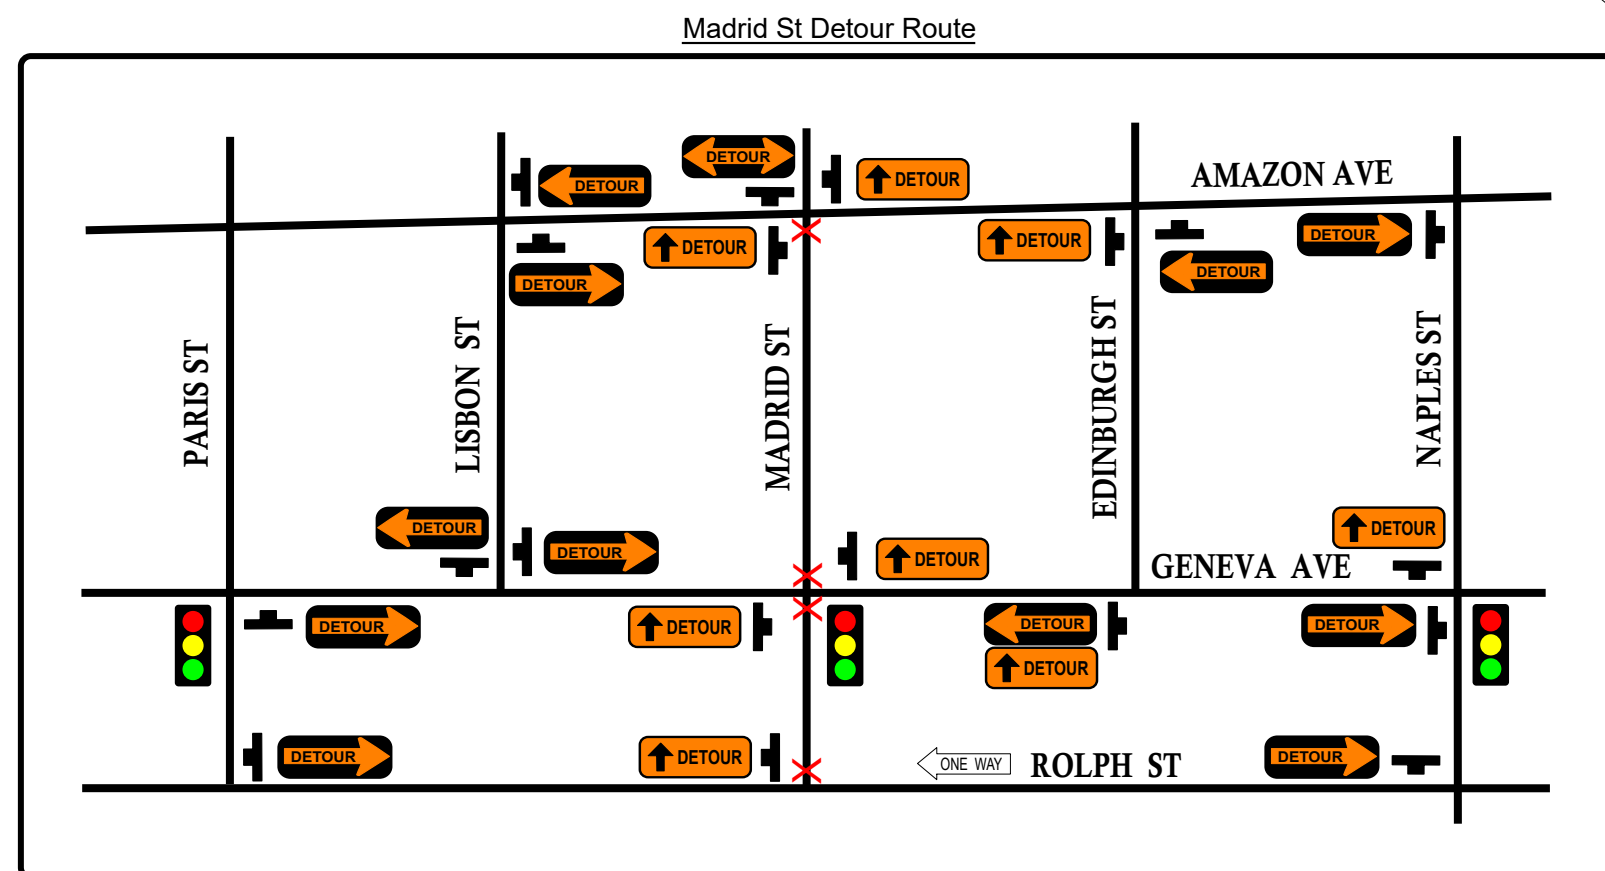


**TRAFFIC CONTROL PLAN**  
**MISSION ST & GENEVA AVE IMPROVEMENT PROJECT - 0000005626**  
**GRIND AND PAVE - GENEVA AVE, MADRID ST TO NAPLES ST**

Traffic Lane Requirements Number and Width of Lanes					
STREET	TIME	NORTHBOUND	SOUTHBOUND	EASTBOUND	WESTBOUND
		GRINDING AND PAVING WORK**			
Paris St to Prague St (MC) β @	8AM – 9AM (M-F)	-	-	1@12'	Full Rdwy
	9AM – 4PM (M-F)	-	-	1@12'	1@12'
	At Other Times	-	-	Full Rdwy	Full Rdwy

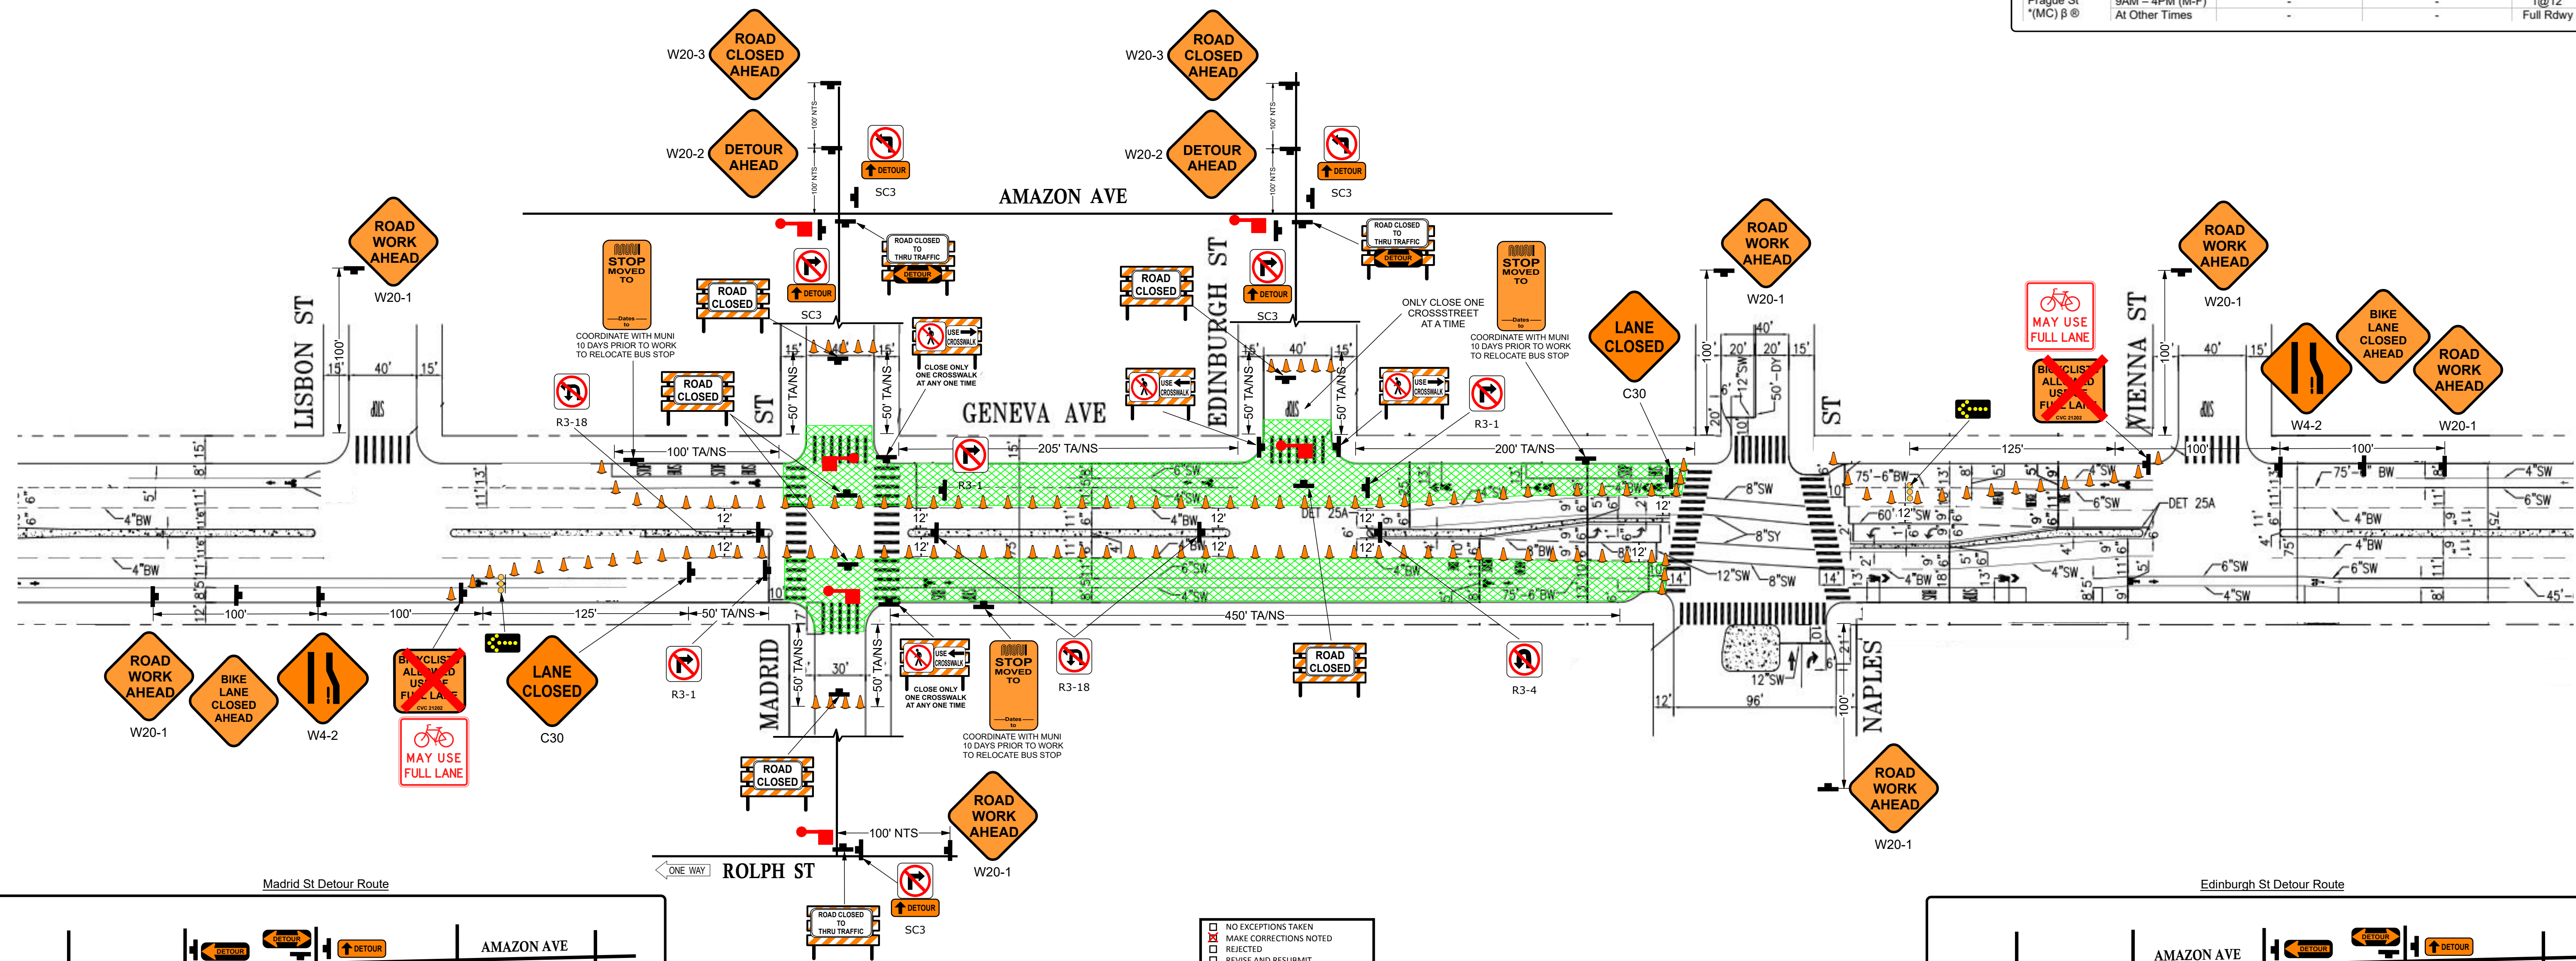

NO EXCEPTIONS TAKEN  
 MAKE CORRECTIONS NOTED  
 REJECTED  
 REVISE AND RESUBMIT  
 SUBMIT SPECIFIED ITEM(S)

Review is only for general conformance with the design concept of the project and general compliance with the requirements of the contract documents. Any action shown is subject to the requirements of the plans and specifications. Contractor's responsibilities include, but are not limited to actual dimensions which shall be confirmed and correlated at the job site, preferred fabrication processes and techniques of construction; coordination of the contractor's work with that of all other trades; and the satisfactory performance of the contractor's work.

Sustainable Streets Division  
 San Francisco Municipal Transportation Agency  
 City and County of San Francisco  
 By: *Justin Jones* DP Date: **10/26/23**



**Legend**

- 28" Traffic Cone
- Delineator
- Pedestrian Barricade
- Work Area
- Sign and Stand
- Type I Barricade
- Type III Barricade
- Flagger
- Parking Control Officer
- NTS Not To Scale
- TANS Towaway/No Stopping

**Table 6C-3(CA). Taper Length Criteria for Temporary Traffic Control Zones (for 12 foot Offset Width)**

Speed* S (mph)	Minimum Taper Length** for Width of Offset 12 feet (W)			
	Merging L/2 (feet)	Shifting L/2 (feet)	Shoulder L/3 (feet)	Down Stream (feet)***
20	80	40	27	50
25	125	63	42	50
30	180	90	60	50
35	245	123	82	50
40	320	160	107	50
45	540	270	180	50
50	600	300	200	50
55	660	330	220	50
60	720	360	240	50
65	780	390	260	50
70	840	420	280	50
75	900	450	300	50

\* - Posted speed limit, off-peak 85th-percentile speed prior to work starting, or the anticipated operating speed in mph.  
 \*\* - For other offsets use the following merging taper length formula for L:  
 $L = WS$   
 For speeds of 40 mph or less, L = WS/60  
 For speeds of 45 mph or more, L = WS  
 Where: L = taper length in feet  
 W = width of offset in feet  
 S = posted speed limit, off-peak 85th-percentile speed prior to work, or the anticipated operating speed in mph  
 \*\*\* - Maximum downstream taper length is 100 feet. See Section 6C.08.

**Table 6F-101(CA). Maximum Spacing of Channelizing Devices**

Speed (mph)	Maximum Channelizing Devices Spacing		
	Taper** (feet)	Tangent (feet)	Conflict** (feet)
20	20	40	10
25	25	50	12
30	30	60	15
35	35	70	17
40	40	80	20
45	45	90	22
50	50	100	25
55	50	100	25
60	50	100	25
65	50	100	25
70	50	100	25
75	50	100	25

\* Maximum channelizing device spacing for all speeds on one-lane/two-way tapers is 20 feet.  
 Maximum channelizing device spacing for all speeds on downstream tapers is 20 feet.  
 All other tapers are as shown.  
 \*\* Use on intermediate and short-term projects for taper and tangent sections where there are no pavement markings or where there is a conflict between existing pavement markings and channelizing devices.


**Table 6C-1. Recommended Advance Warning Sign Spacing**

Road Type	Distance Between Signs**		
	A	B	C
Urban - 25 mph or less***	100 feet	100 feet	100 feet
Urban - more than 25 mph to 40 mph***	250 feet	250 feet	250 feet
Urban - more than 40 mph***	350 feet	350 feet	350 feet
Rural	500 feet	500 feet	500 feet
Expressway/Freeway	1,000 feet	1,500 feet	2,640 feet

\*\* The column headings A, B, and C are the dimensions shown in Figures 6H-1 through 6H-46. The A dimension is the distance from the transition or point of restriction to the first sign. The B dimension is the distance between the first and second signs. The C dimension is the distance between the second and third signs. (The "first sign" is the sign in a three-sign series that is closest to the TTC zone. The "third sign" is the sign that is furthest upstream from the TTC zone.)  
 \*\*\* Posted speed limit, off-peak 85th-percentile speed prior to work starting, or other anticipated operating speed in mph.

**Plan Scale**

**1" = 50'**

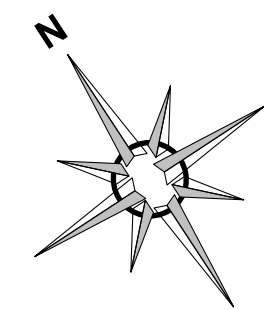

3450 3RD ST #3C  
 SAN FRANCISCO, CA 94124  
 415-206-1700 PHONE  
 415-206-1711 FAX  
 INFO@CMCTRAFFIC.COM

LICENSE NO. 792059  
 CLASS A, 31, C21  
 WBE/SBE/LBE/DBE CERTIFIED  
 WWW.CMCTRAFFIC.COM

Date: 10/20/2023 Author: KMH Project: MISSION ST AND GENEVA AVE  
 CLIENT: BAUMAN LANDSCAPE Location: SAN FRANCISCO TCP: 133  
 CMC Job #: 3405 REV: 1

**Comments:**

- 1) WORK HOURS: SEE TRAFFIC LANE REQUIREMENTS
- 2) CONTRACTOR TO VERIFY EXISTING STRIPING IS ACCURATE PRIOR TO START OF WORK.
- 3) ALL TRAFFIC CONTROL SHALL CONFORM TO THE LATEST EDITION OF CA MUTCD.
- 4) ALL TRAFFIC CONTROL DEVICES SHALL BE RETROREFLECTIVE IF SETUP DURING HOURS OF DARKNESS.
- 5) GRINDING AND/OR PAVING WORK WILL BE ALLOWED UP TO TWO (2) CONSECUTIVE BLOCKS AND TWO (2) CONSECUTIVE INTERSECTIONS MAXIMUM AT A TIME AND ALL TWO (2) CONSECUTIVE BLOCKS AND TWO (2) CONSECUTIVE INTERSECTIONS MUST BE PAVED WITHIN 120 HOURS FROM THE START OF GRINDING WORK, WITHOUT EXCEPTION.
- 6) DURING INTERSECTION GRINDING AND PAVING WORK, THE CROSS STREET MAY BE INTERRUPTED FOR UP TO A MAXIMUM OF TEN (10) MINUTES FOR RESIDENTIAL AREAS
- 7) THE CONTRACTOR SHALL NOT CLOSE MORE THAN ONE CROSS STREET AT THE SAME TIME