

- ☐ NO EXCEPTIONS TAKEN
☒ MAKE CORRECTIONS NOTED
☐ REJECTED
☐ REVISE AND RESUBMIT
☐ SUBMIT SPECIFIED ITEM(S)
- Review is only for general conformance with the design concept of the project and general compliance with the requirements of the contract documents. Any action shown is subject to the requirements of the plans and specifications. Contractor's responsibilities include, but are not limited to actual dimensions which shall be confirmed and correlated at the job site; preferred fabrication processes and techniques of construction; coordination of the contractor's work with that of all other trades; and the satisfactory performance of the contractor's work.

Sustainable Streets Division
San Francisco Municipal Transportation Agency
City and County of San Francisco


By: *[Signature]* Date: 11/16/22



Plan Scale
1" = 50'

- Legend**
- Type III Barricade
 - 28" Traffic Cone
 - Delineator
 - Pedestrian Barricade
 - Work Area
 - Sign and Stand
 - Direction of Travel
 - Concrete K-Rail
 - Crash Cushion
 - Not To Scale
 - NTS Tow-Away/No Stopping
 - Parking Control Officer
 - Flagger
 - Type I Barricade
 - Flashing Beacon

TRAFFIC CONTROL PLAN
MISSION ST & GENEVA AVE IMPROVEMENT PROJECT - 0000005626 SEWER
WORK PLAN - GENEVA AVE FROM MADRID ST TO EDINBURGH ST 1

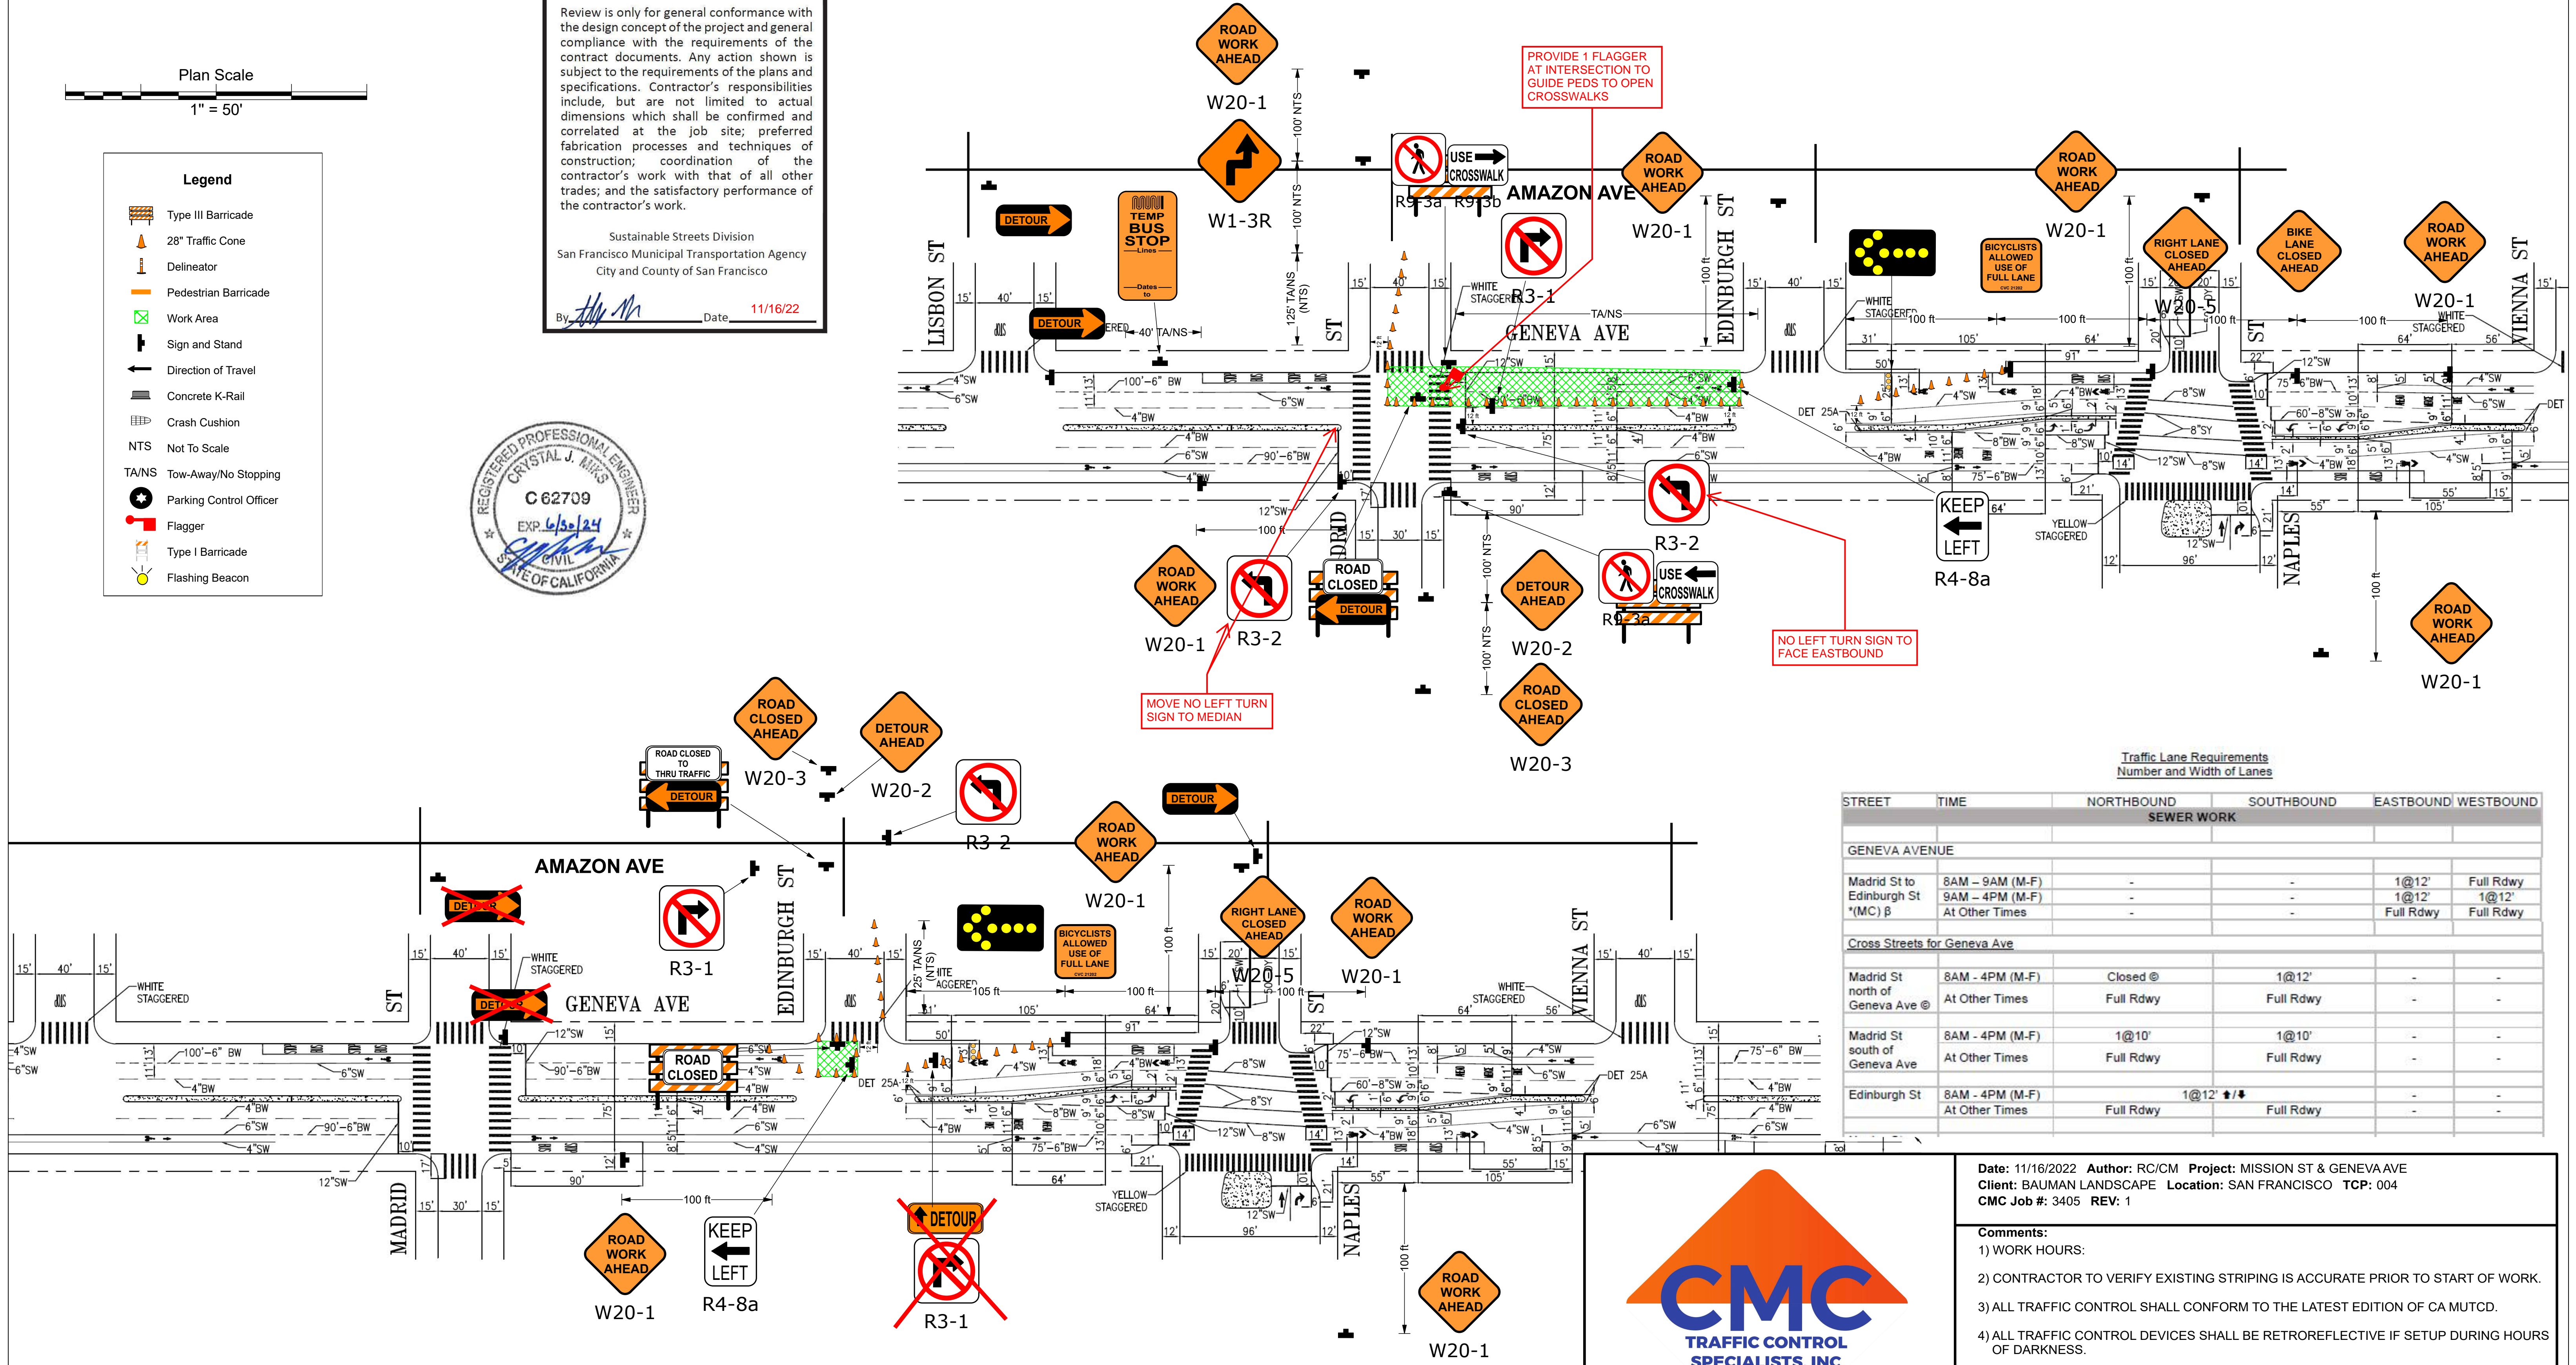

Traffic Lane Requirements
Number and Width of Lanes

STREET	TIME	NORTHBOUND	SOUTHBOUND	EASTBOUND	WESTBOUND
SEWER WORK					
GENEVA AVENUE					
Madrid St to Edinburgh St (M-F)	8AM - 9AM (M-F)	-	-	1@12'	Full Rdwy
Edinburgh St to (M-F)	9AM - 4PM (M-F)	-	-	1@12'	1@12'
At Other Times	At Other Times	-	-	Full Rdwy	Full Rdwy
Cross Streets for Geneva Ave					
Madrid St north of Geneva Ave @	8AM - 4PM (M-F)	Closed @	1@12'	-	-
At Other Times	At Other Times	Full Rdwy	Full Rdwy	-	-
Madrid St south of Geneva Ave	8AM - 4PM (M-F)	1@10'	1@10'	-	-
At Other Times	At Other Times	Full Rdwy	Full Rdwy	-	-
Edinburgh St	8AM - 4PM (M-F)	1@12' ↑/↓	-	-	-
At Other Times	At Other Times	Full Rdwy	Full Rdwy	-	-



3450 3RD ST #3G
SAN FRANCISCO, CA 94124
415-206-1700 PHONE
415-206-1711 FAX
INFO@CMCTRAFFIC.COM

LICENSE NO 792059
CLASS A, 31, C21
WBE/SBE/LBE/DBE CERTIFIED
WWW.CMCTRAFFIC.COM

Date: 11/16/2022 Author: RC/CM Project: MISSION ST & GENEVA AVE
Client: BAUMAN LANDSCAPE Location: SAN FRANCISCO TCP: 004
CMC Job #: 3405 REV: 1

- Comments:**
- 1) WORK HOURS:
 - 2) CONTRACTOR TO VERIFY EXISTING STRIPING IS ACCURATE PRIOR TO START OF WORK.
 - 3) ALL TRAFFIC CONTROL SHALL CONFORM TO THE LATEST EDITION OF CA MUTCD.
 - 4) ALL TRAFFIC CONTROL DEVICES SHALL BE RETROREFLECTIVE IF SETUP DURING HOURS OF DARKNESS.
 - 5) MAINTAIN LOCAL ACCESS TO BUSINESSES AND RESIDENTS AT ALL TIME.
 - 6) THE CONTRACTOR SHALL NOT PREVENT OR DELAY THE OPERATION OF MASS TRANSIT VEHICLES AT ANY TIME.
 - 7) THE CONTRACTOR SHALL PERFORM THE APPROPRIATE MEASURES TO ENSURE THE SAFETY OF BICYCLISTS ON ALL STREET ON WHICH THERE IS CONSTRUCTION.